



LOWER GROUND FLOOR PLAN

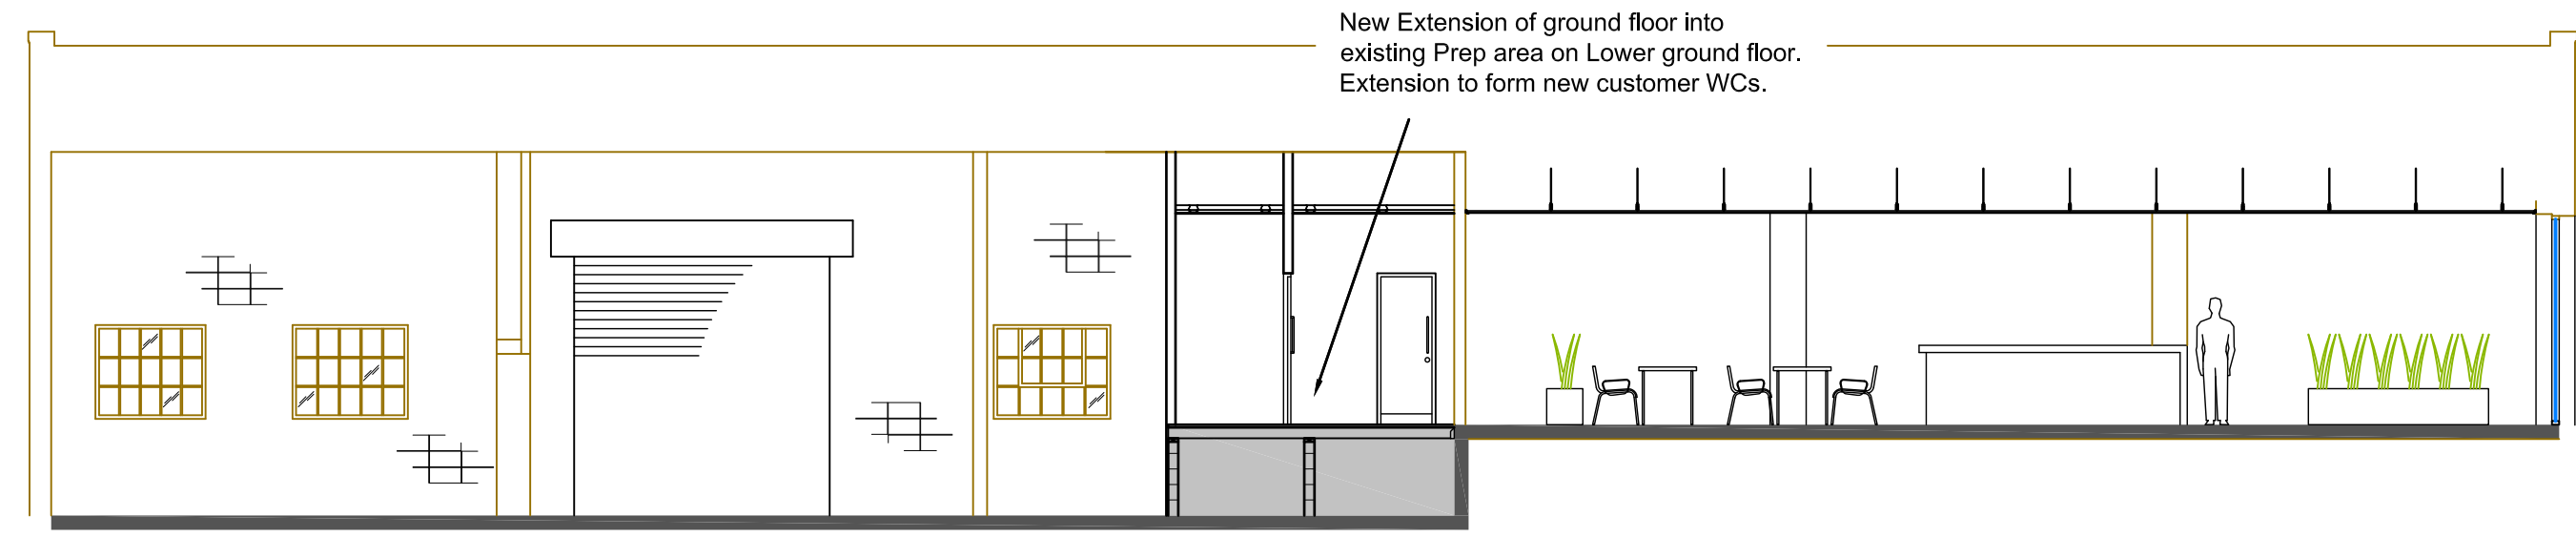

SECTION C

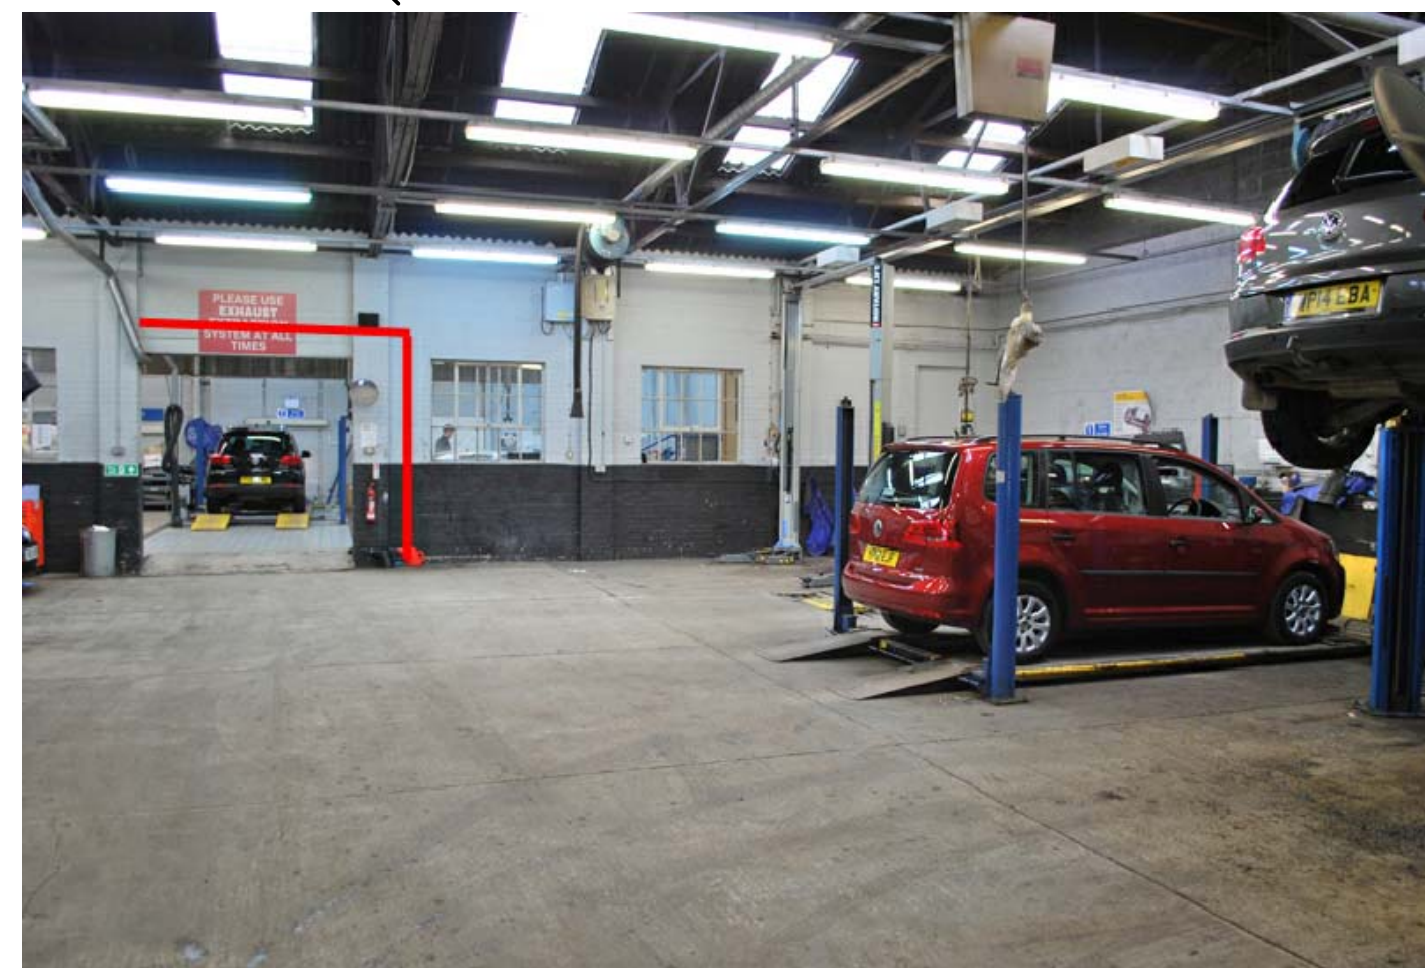

Photograph of Extg opening with mark up for new trimming lintel

Rev C Consultation bay proposal omitted KJC 29/05/15

Project VW ROTHERHAM, JCT600 BAWTRY RD, ROTHERHAM		
VRC RE-FIT		
<b>Axis 3 Design</b> architectural design and services Unit 10 Athena Court Athena Drive Tachbrook Park Warwick CV34 6RT Telephone : 01926 833570		
Drawing PROPOSED UPPER FLOOR PLAN		
Scale 1:100 @ A1	Date 22/03/15	Drawn KJH
Job No. P199	Drawing No. 05	Revision C

Tender